

1007 EAST FOURTEENTH AVENUE (House)
Ybor City
Tampa
Hillsborough County
Florida

HABS No. FL-485

HABS
FL-485

PHOTOGRAPHS

WRITTEN HISTORICAL AND DESCRIPTIVE DATA

Historic American Buildings Survey
National Park Service
Southeast Region
Department of the Interior
Atlanta, Georgia 30303

HISTORIC AMERICAN BUILDINGS SURVEY

1007 EAST FOURTEENTH AVENUE (House)

HABS No. FL-485

Location: 1007 East Fourteenth Avenue, Tampa, Hillsborough County, Florida

Significance: This building's architectural and historical significance is derived from its contribution to the Ybor City National Register Historic Landmark District. Ybor City is a section of Tampa founded and built by Vicente M. Ybor and Ignacio Haya as a cigar-manufacturing center and town. This company town was planned by Gavino Gutierrez to include cigar factories, workers housing, public spaces, and commercial buildings. This district is significant for its importance to Tampa's architectural heritage, as it contains many of the City's best remaining examples of late-nineteenth century and early-twentieth century domestic, religious, commercial, and industrial buildings. This house represents cigar factory worker housing within the larger context of the cigar manufacturing company town. This Craftsman Bungalow residence is representative of the larger collection of worker housing in Ybor City.

Description: This rectangular, one-story Craftsman Bungalow has a wood frame structural system and rests on brick piers with wood lattice infill. The gabled roof is surfaced with composition shingles, and the exterior is sheathed in drop siding. An integral, full-width porch is featured on the north elevation. The porch is supported by battered columns that rest on brick piers and has a tiled landing. Fenestration consists of wood double-hung sash windows with one-over-one light configurations. Exterior ornamentation includes cornerboards, vents, exposed rafter tails, and wood window surrounds. A historic, gabled-roofed wood frame addition attached to the south elevation has an exterior entrance on the east side. A historic wood-frame garage is located southeast of the building. A low concrete knee wall delineates the front yard. The kitchen features original built-in glass cabinets and a rounded storage shelf with a built-in closet.

History: This residence was built ca. 1913 on the south side of East Fourteenth Avenue, four lots east of North Tenth Street, within the larger area of Ybor City that contained residences, factories, and commercial buildings. It is a single-family private residence that exhibits minor alterations and remains in good condition. Ybor City was platted in the 1890s and was completely built out by the mid-1920s. At the time of construction, cigar manufacturing was at its peak and the original residents were probably employed at one of the factories.


Sources:

Charleton, James H. Ybor City Historic. *National Register of Historic Places Registration Form*, 1990.

Mormino, Gary R. and Anthony P. Pizzo. *The Immigrant World of Ybor City*. University of Illinois Press: Chicago, 1987.

Historian:

Kisa Hooks and Brian Koepnick, Janus Research, June 14, 2004

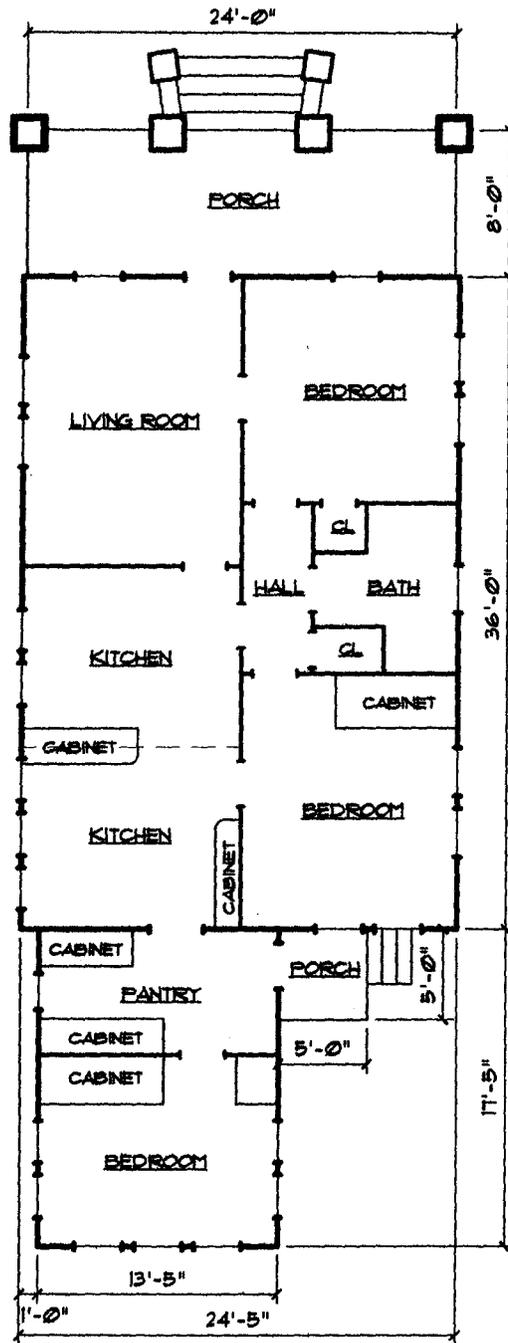

FLOOR PLAN SKETCH


SCALE 3/32" = 1'-0"

DATE DRAWN: June 15, 2004
 DRAWN BY: Jo-Anne Peck


1007 EAST FOURTEENTH AVENUE (House)
 YBOR CITY, TAMPA, FL




1001 EAST FOURTEENTH AVENUE (Garage)
HABS No. FL- 485 (PAGE 3)

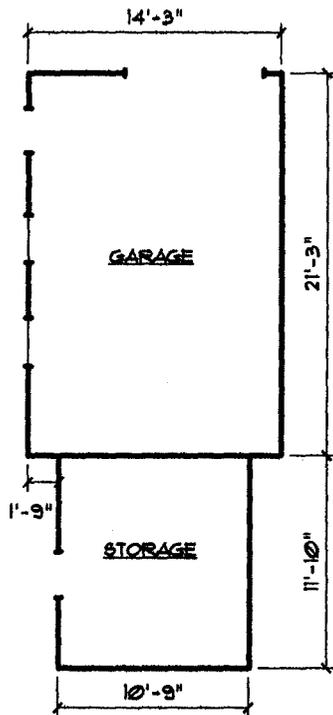

FLOOR PLAN SKETCH		SCALE 3/32" = 1'-0"
DATE DRAWN: June 15, 2004 DRAWN BY: Jo-Anne Peck	1001 EAST FOURTEENTH AVENUE (Garage) YBOR CITY, TAMPA, FL	

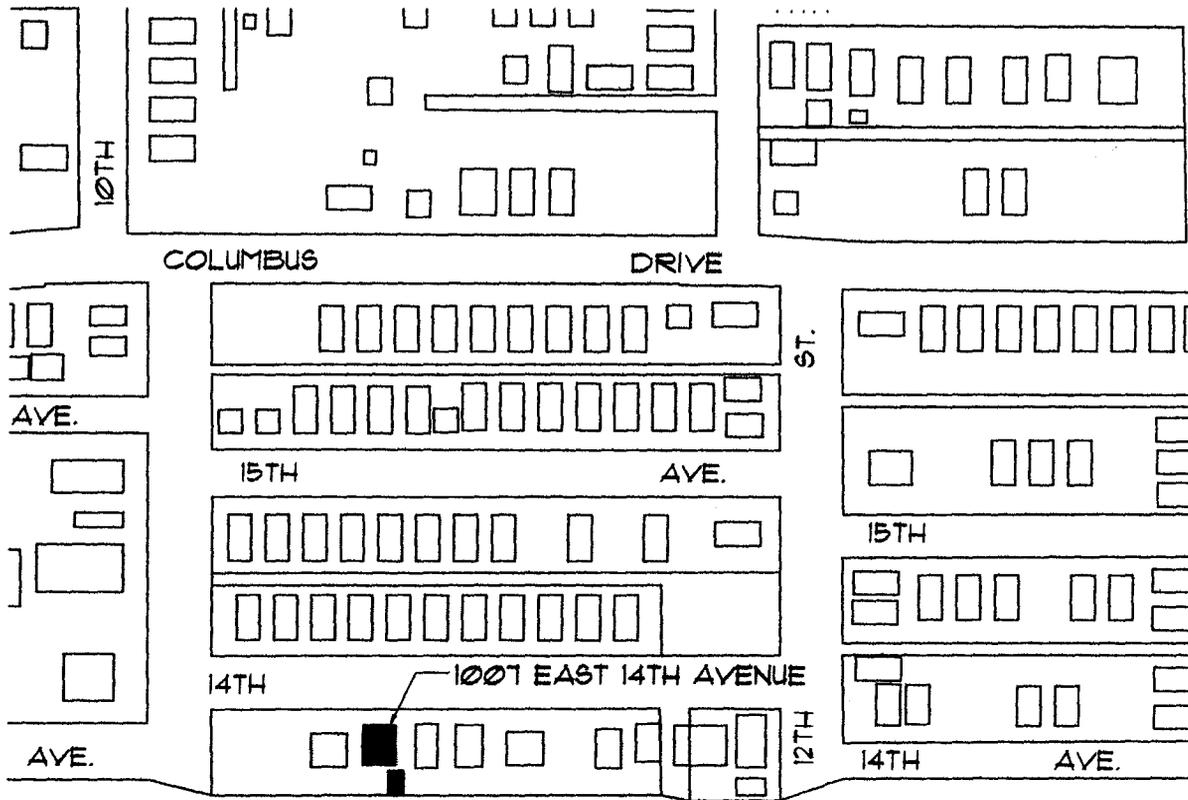

US INTERSTATE FOUR

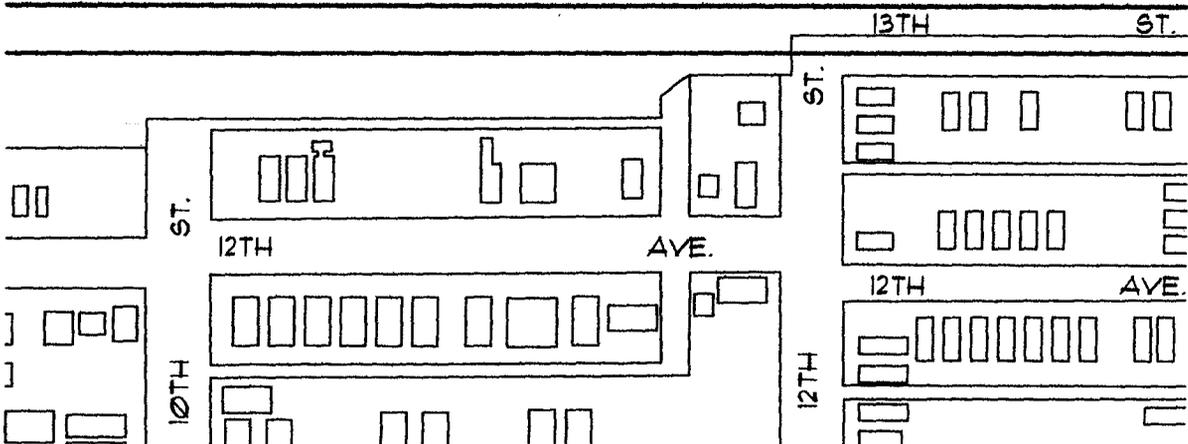

LOCATION MAP

NOT TO SCALE

DATE DRAWN: June 15, 2004
 DRAWN BY: Jo-Anne Peck

1007 EAST FOURTEENTH AVENUE (House)
 YBOR CITY, TAMPA, FL

