

HISTORIC AMERICAN BUILDINGS SURVEY

INDEX TO PHOTOGRAPHS

HABS No. MI-427-Q

**ALLEN PARK VETERANS
ADMINISTRATION HOSPITAL
BUILDING 67**


(Laboratory)

Southfield Expressway and Outer Drive
Allen Park, Wayne County, Michigan


Photographer: Andrew Baugnet, February 2002

- MI-427-Q-1 THREE-QUARTER VIEW OF LABORATORY BUILDING AT
VETERANS ADMINISTRATION HOSPITAL, FACING EAST
- MI-427-Q-2 THREE-QUARTER VIEW OF LABORATORY BUILDING AT
VETERANS ADMINISTRATION HOSPITAL, FACING WEST
- MI-427-Q-3 INTERIOR VIEW OF ROOM 107 IN LABORATORY BUILDING AT
VETERANS ADMINISTRATION HOSPITAL, FACING SOUTHEAST

ALLEN PARK VETERANS
ADMINISTRATION HOSPITAL
BUILDING 67
(Laboratory)
HABS No. MI-427-Q
KEY TO PHOTOGRAPHS
(Page 2)

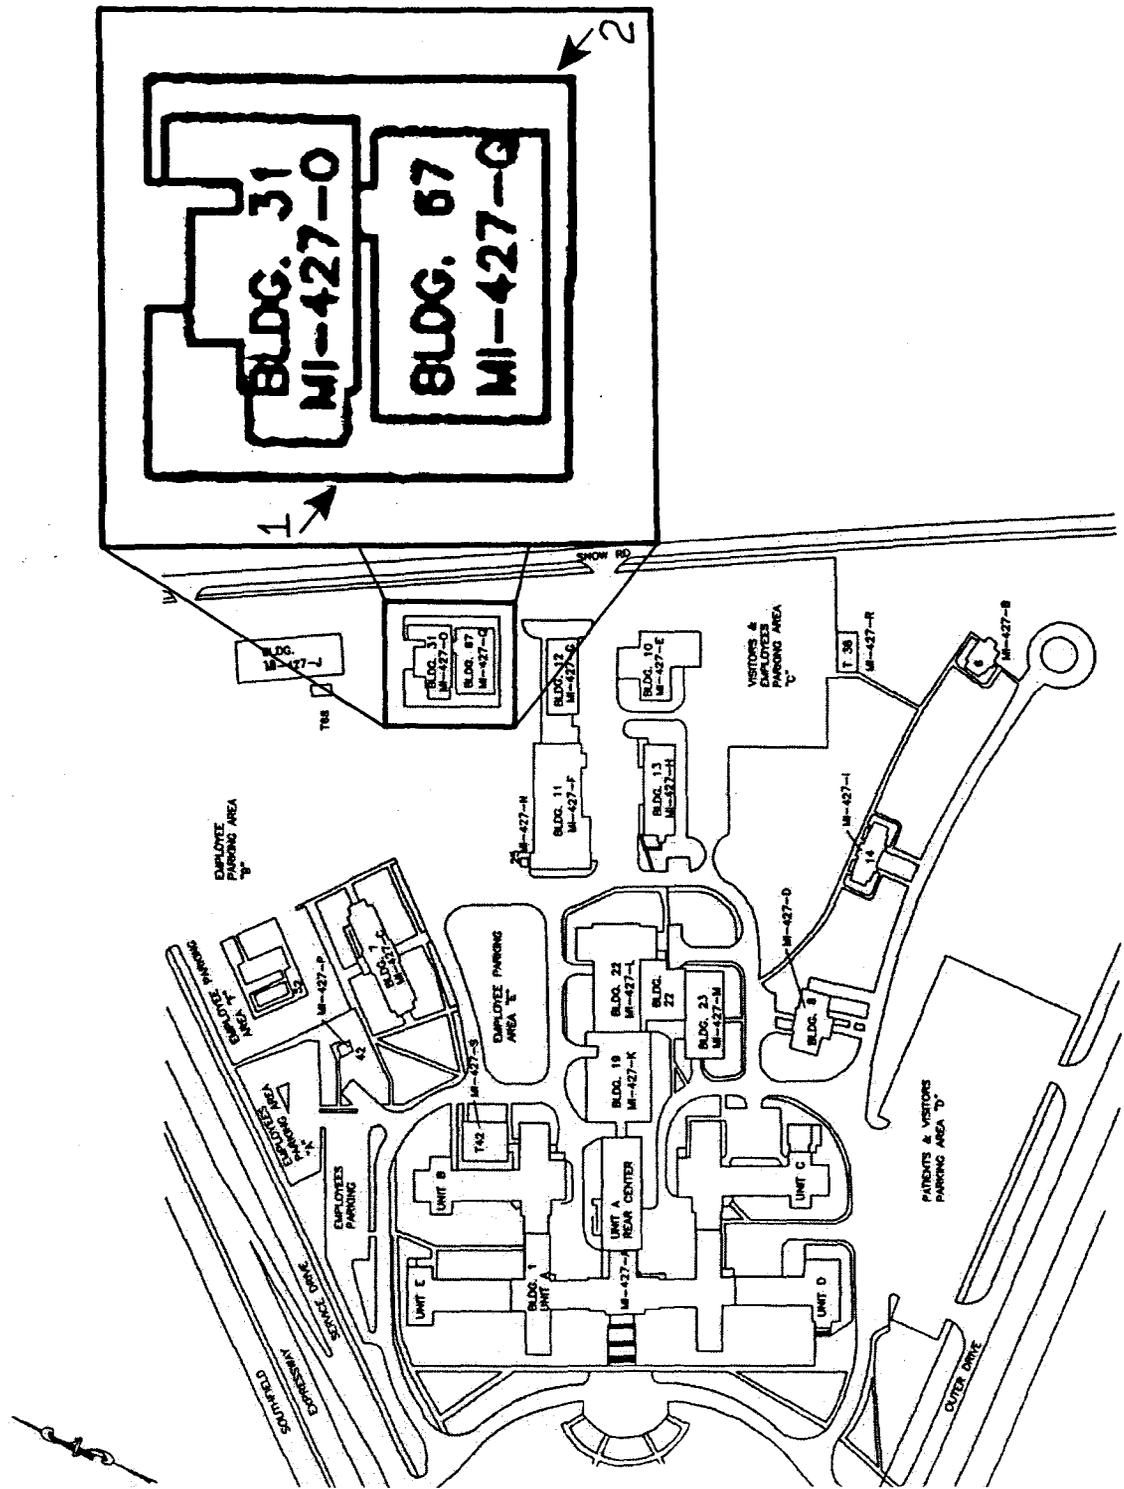

ALLEN PARK VETERANS
 ADMINISTRATION HOSPITAL
 BUILDING 67
 (Laboratory)
 HABS No. MI-427-Q
 KEY TO PHOTOGRAPHS
 (Page 3)

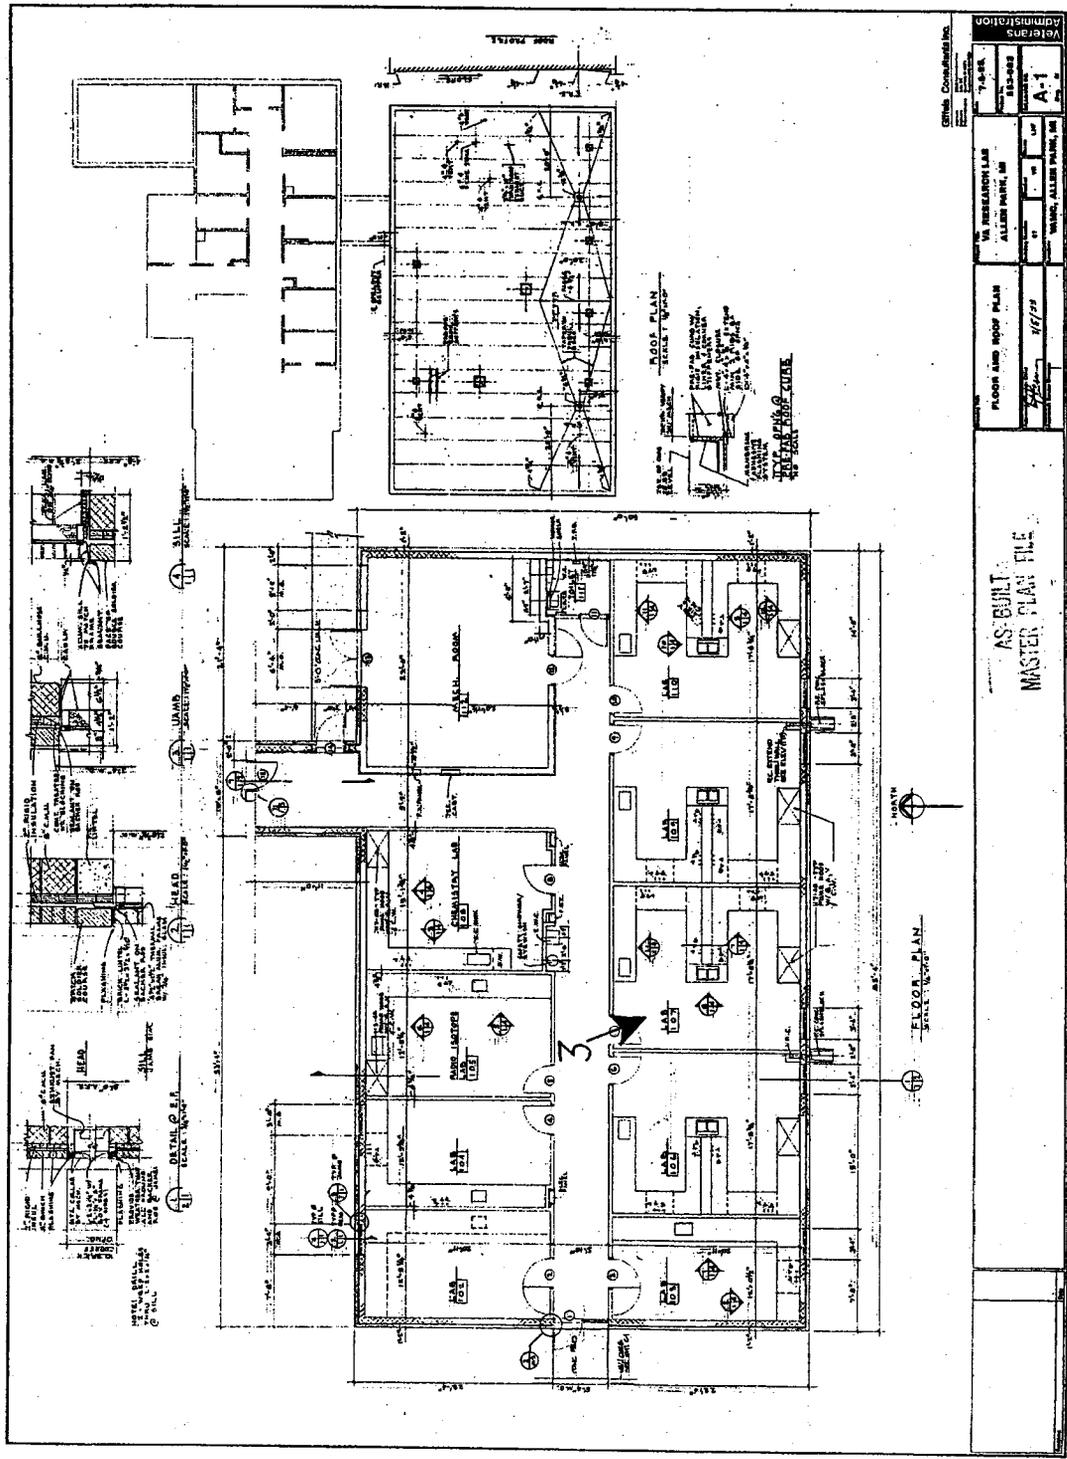

Veterans Administration	
7-424	83-008
A-1	
FLOOR AND ROOF PLAN	
NO. REVISIONS	DATE
1	1/1/55
BY: [Signature]	
CHECKED BY: [Signature]	
PROJECT: ALLEN PARK, MI	

AS-BUILT
 MASTER PLAN FILE

GENERAL CONTRACTOR: [Name]

ARCHITECT: [Name]

DATE: [Date]

SCALE: 1/8" = 1'-0"